

Targeted Consultation

Frodsham Marshes

West Corridor


HyNet North West
Hydrogen Pipeline

Delivering clean growth




The Applicant is proposing an extension of the Project's Draft Order Limits (boundary of development area) at Frodsham Marshes along ditches south of Moorditch Lane and east of Hapsford Lane. This land is proposed as ecological mitigation and it is intended to provide suitable alternative habitats for water voles.


A further addition of land at Frodsham Marshes is an increase in the width of the Draft Order Limits of approximately 2.5m towards the bank of the ditch predominantly to the east of the junction between Brook Furlong and Moorditch Lane. This is to maximise the land available to the Project, to support avoidance of the existing telecommunications tower.

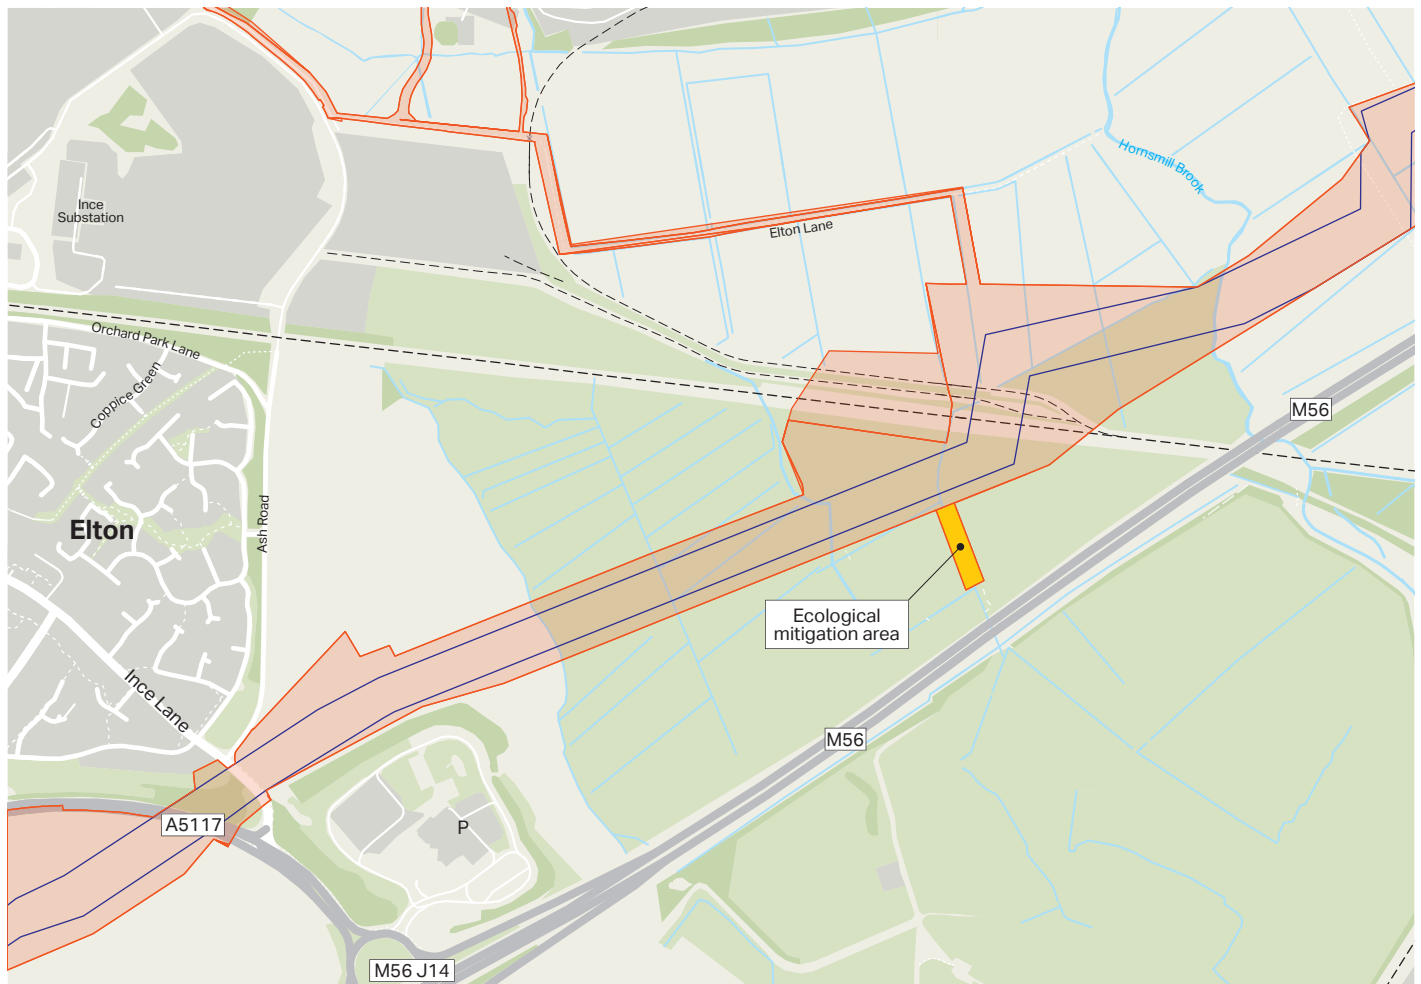Proposed changes are illustrated in the maps below. Information on how to provide feedback is included on the following page.




Map data © OpenStreetMap contributors, Microsoft, Facebook, Inc. and its affiliates, Esri Community Maps contributors, Map layer by Esri

-  Targeted consultation area
-  Red line boundary
-  Area where pipeline could be located

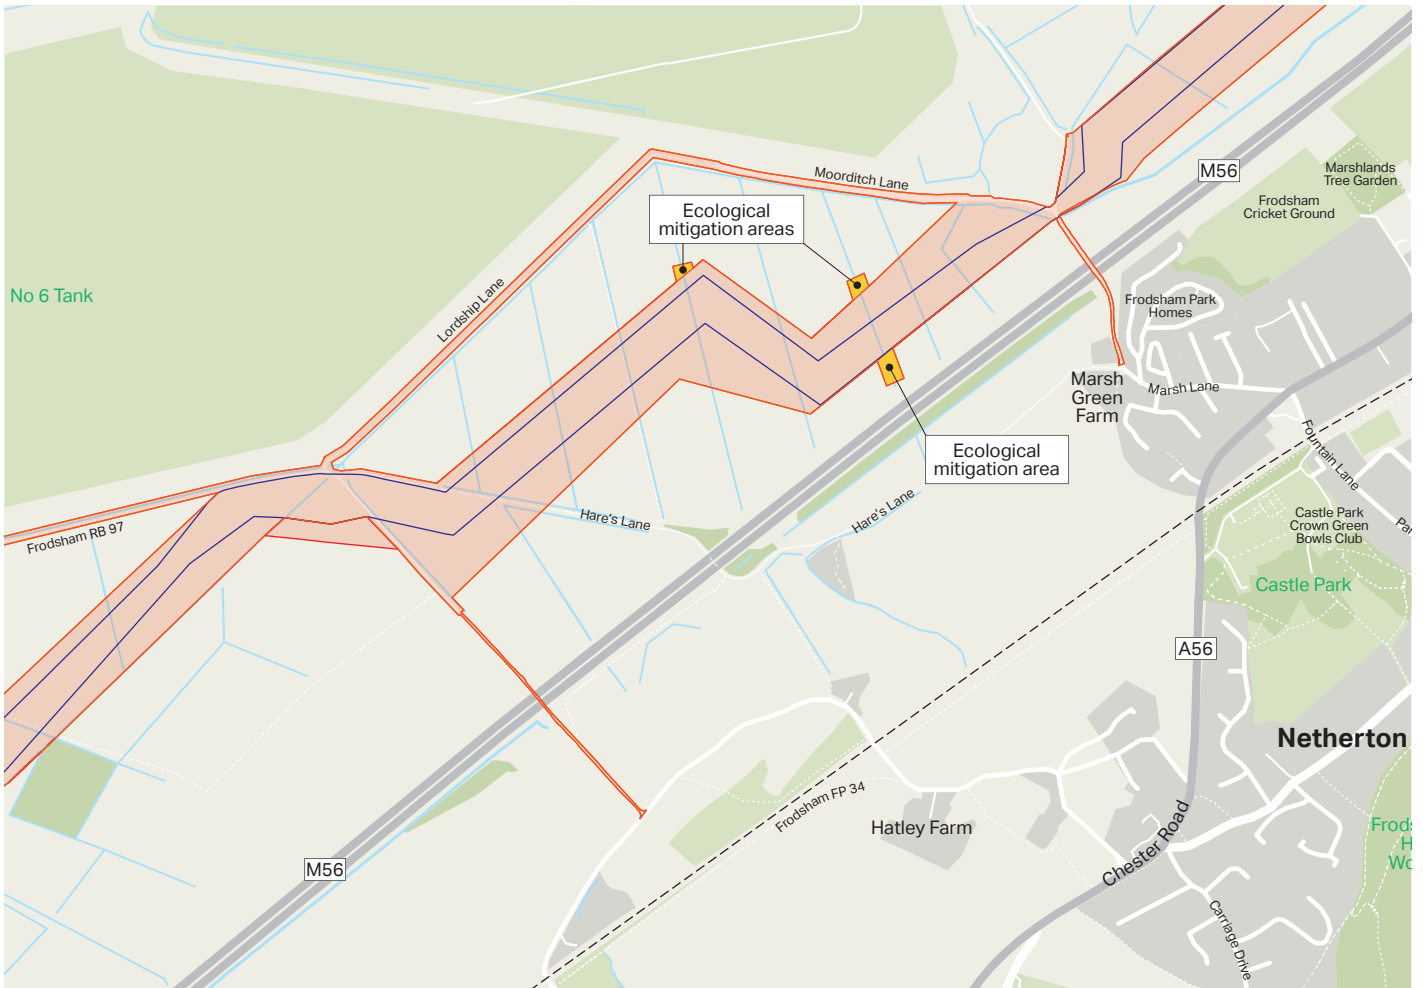


Map data © OpenStreetMap contributors, Microsoft, Facebook, Inc. and its affiliates, Esri Community Maps contributors, Map layer by Esri

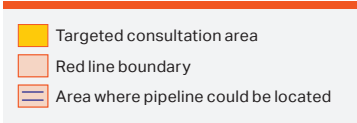

How to provide feedback

Please share your thoughts on these proposed extensions of the Draft Order Limits at Frodsham Marshes.


If you have any comments on this proposed change, please send your feedback to the project team by:

 **Email:**
info@hynethydrogenpipeline.co.uk

 **Write to us:**
FREEPOST HYNET NWHP

When providing your response:


- **Please include your name and address** to help us better understand your feedback
- **Please confirm which amendment you are responding to**, and the nature of your interest in the land affected by the scheme. Full descriptions of changes can be found in the Draft ES Addendum in our Knowledge Hub:

 **www.hynethydrogenpipeline.co.uk/knowledge-hub/**

Next steps

Your feedback will be considered as we continue to finalise our design. Following the targeted consultation, we will consider stakeholder comments and review these amendments in light of the feedback gathered.

If you have any questions on how to provide feedback, please contact the project team by:


 **Email:**
info@hynethydrogenpipeline.co.uk

 **Call: 0800 860 6261**

Safely managing your data

Cadent will consider and have regard to all responses when developing the application for a DCO once consultation has closed. Responses will form the basis of a Consultation Report that will be one of the factors taken into consideration by the Secretary of State when deciding whether the Application can be accepted for examination. It should therefore be known that any responses could be communicated to others as part of the Consultation Report. Any details you provide to us will be subject to our privacy policy notice.

The Project's privacy policy notice can be found at:

 **www.hynethydrogenpipeline.co.uk/contact-us/privacy-policy**

Personal details will be held securely and solely for the purposes connected with this consultation, the DCO process and further development of the Project, including maintaining our gas network. Personal details will not be disclosed to any third parties except where Cadent is required to do so by law (e.g. where required to respond to a formal Freedom of Information Request).

For confidential support, contact Shout



Access this service by texting the word **'PIPELINE'** to **85258** to speak silently by text message to a Shout Volunteer